


**WARNING**  
 THIS SURVEY IS FOR INFORMATIONAL PURPOSES ONLY. IT IS NOT TO BE USED FOR CONSTRUCTION OR AS A BASIS FOR ANY LEGAL ACTION. THE SURVEYOR HAS CONDUCTED A VISUAL INSPECTION OF THE PROPERTY AND HAS FOUND NO EVIDENCE OF ANY UNRECORDED INTERESTS. HOWEVER, THE SURVEYOR DOES NOT GUARANTEE THE ACCURACY OF THE SURVEY OR THE ABSENCE OF UNRECORDED INTERESTS. THE SURVEYOR'S LIABILITY IS LIMITED TO THE PROFESSIONAL SERVICES PROVIDED. THE SURVEYOR IS NOT RESPONSIBLE FOR ANY DAMAGE TO PERSONS OR PROPERTY CAUSED BY THE USE OF THIS SURVEY. THE SURVEYOR'S LIABILITY IS LIMITED TO THE PROFESSIONAL SERVICES PROVIDED. THE SURVEYOR IS NOT RESPONSIBLE FOR ANY DAMAGE TO PERSONS OR PROPERTY CAUSED BY THE USE OF THIS SURVEY.

- TABLE OF NOTES**
1. ALL DIMENSIONS ARE IN FEET AND DECIMALS THEREOF.
  2. COMMON WALLS ARE SHOWN AS CENTER LINES UNLESS OTHERWISE NOTED.
  3. ALL DIMENSIONS ARE TO THE CENTER OF THE ROAD UNLESS OTHERWISE NOTED.
  4. ALL DIMENSIONS ARE TO THE CENTER OF THE ROAD UNLESS OTHERWISE NOTED.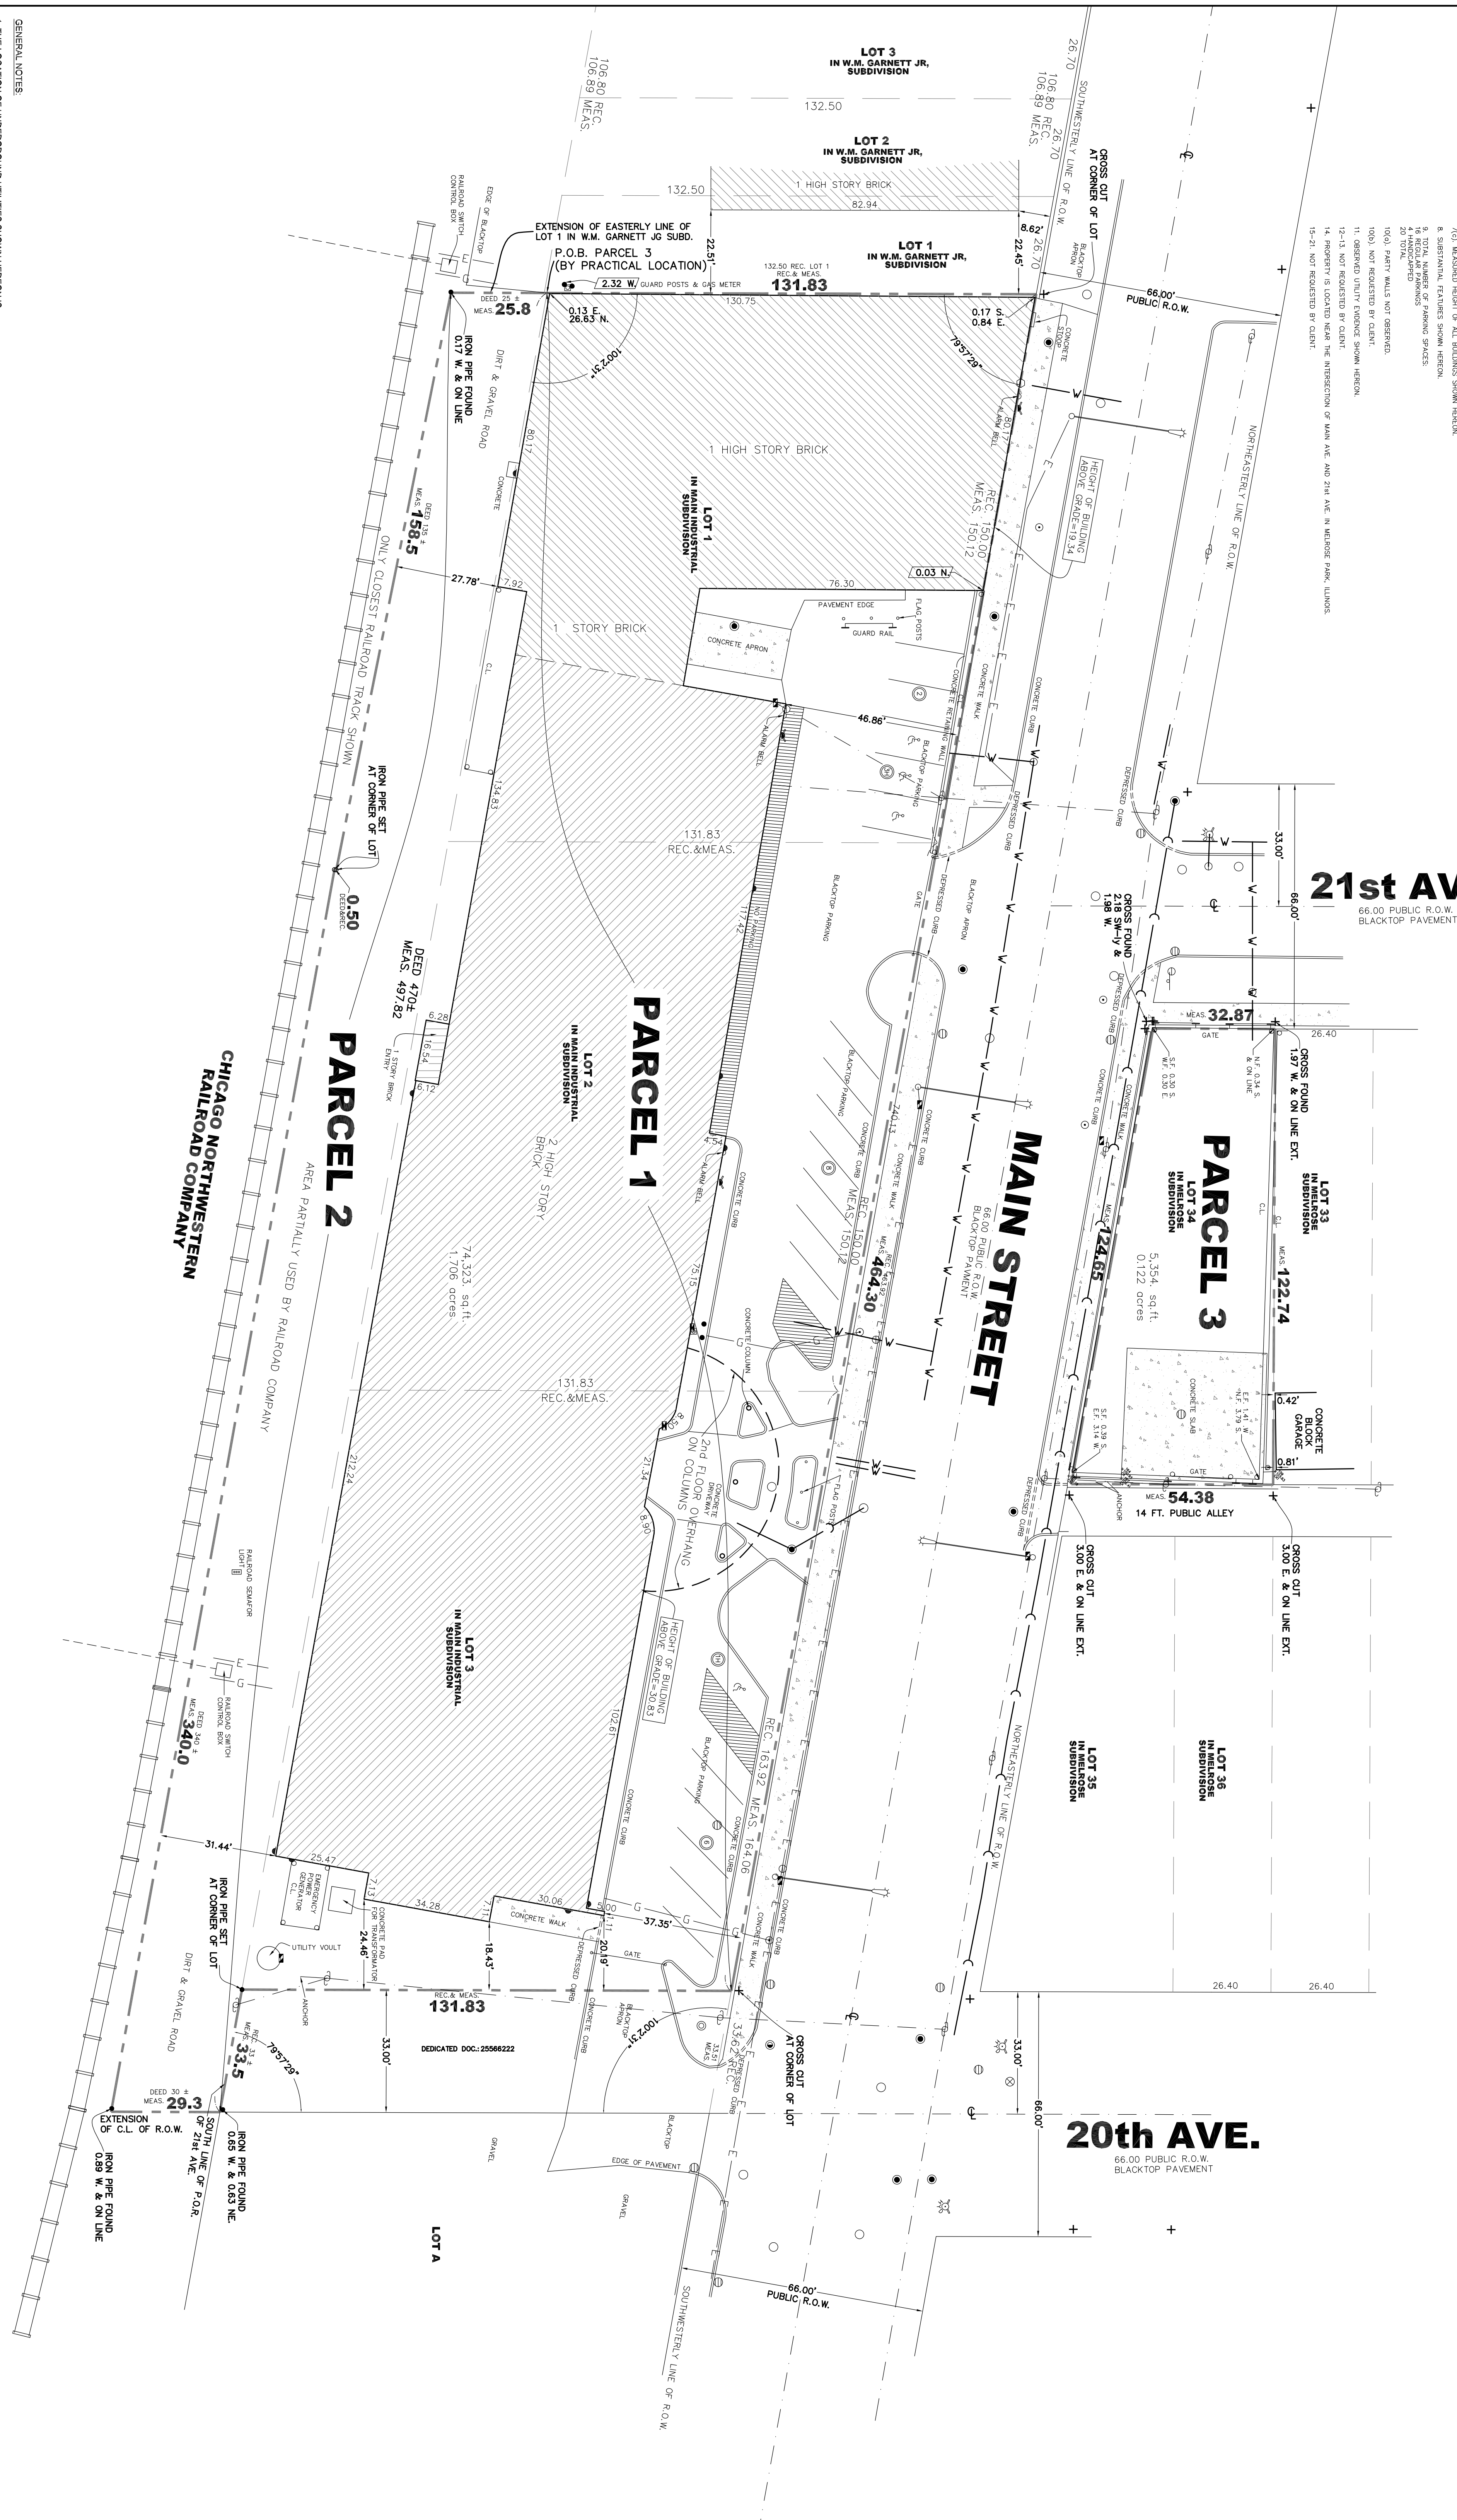
**GENERAL NOTES**

1. THE LOCATION OF UNDERGROUND UTILITIES SHOWN HEREON IS BASED ON RECORD DRAWINGS AND FIELD SURVEY DATA. THE SURVEYOR HAS CONDUCTED A VISUAL INSPECTION OF THE PROPERTY AND HAS FOUND NO EVIDENCE OF ANY UNRECORDED INTERESTS. HOWEVER, THE SURVEYOR DOES NOT GUARANTEE THE ACCURACY OF THE SURVEY OR THE ABSENCE OF UNRECORDED INTERESTS. THE SURVEYOR'S LIABILITY IS LIMITED TO THE PROFESSIONAL SERVICES PROVIDED. THE SURVEYOR IS NOT RESPONSIBLE FOR ANY DAMAGE TO PERSONS OR PROPERTY CAUSED BY THE USE OF THIS SURVEY.

**LEGEND**

Symbol	Description
Circle with dot	Survey Station
Circle with cross	Corner Marker
Circle with 'X'	Iron Pipe Round
Circle with 'S'	Steel Pipe Round
Circle with 'C'	Cast Iron Pipe Round
Circle with 'W'	Water Main
Circle with 'G'	Gas Main
Circle with 'E'	Electric Conduit
Circle with 'F'	Fire Main
Circle with 'T'	Telephone Conduit
Circle with 'M'	Miscellaneous
Circle with 'U'	Unknown
Circle with 'V'	Vertical Curve
Circle with 'H'	Horizontal Curve
Circle with 'R'	Right of Way
Circle with 'P'	Proposed
Circle with 'A'	As Shown
Circle with 'B'	Boundary
Circle with 'C'	Center
Circle with 'D'	Distance
Circle with 'E'	Elevation
Circle with 'F'	Face
Circle with 'G'	Grade
Circle with 'H'	Height
Circle with 'I'	Intersection
Circle with 'J'	Join
Circle with 'K'	Key
Circle with 'L'	Label
Circle with 'M'	Marker
Circle with 'N'	North
Circle with 'O'	Offset
Circle with 'P'	Point
Circle with 'Q'	Quarter
Circle with 'R'	Radius
Circle with 'S'	Scale
Circle with 'T'	Tangent
Circle with 'U'	Utility
Circle with 'V'	Vertical
Circle with 'W'	Water
Circle with 'X'	Excavation
Circle with 'Y'	Yield
Circle with 'Z'	Zone